


stop 3

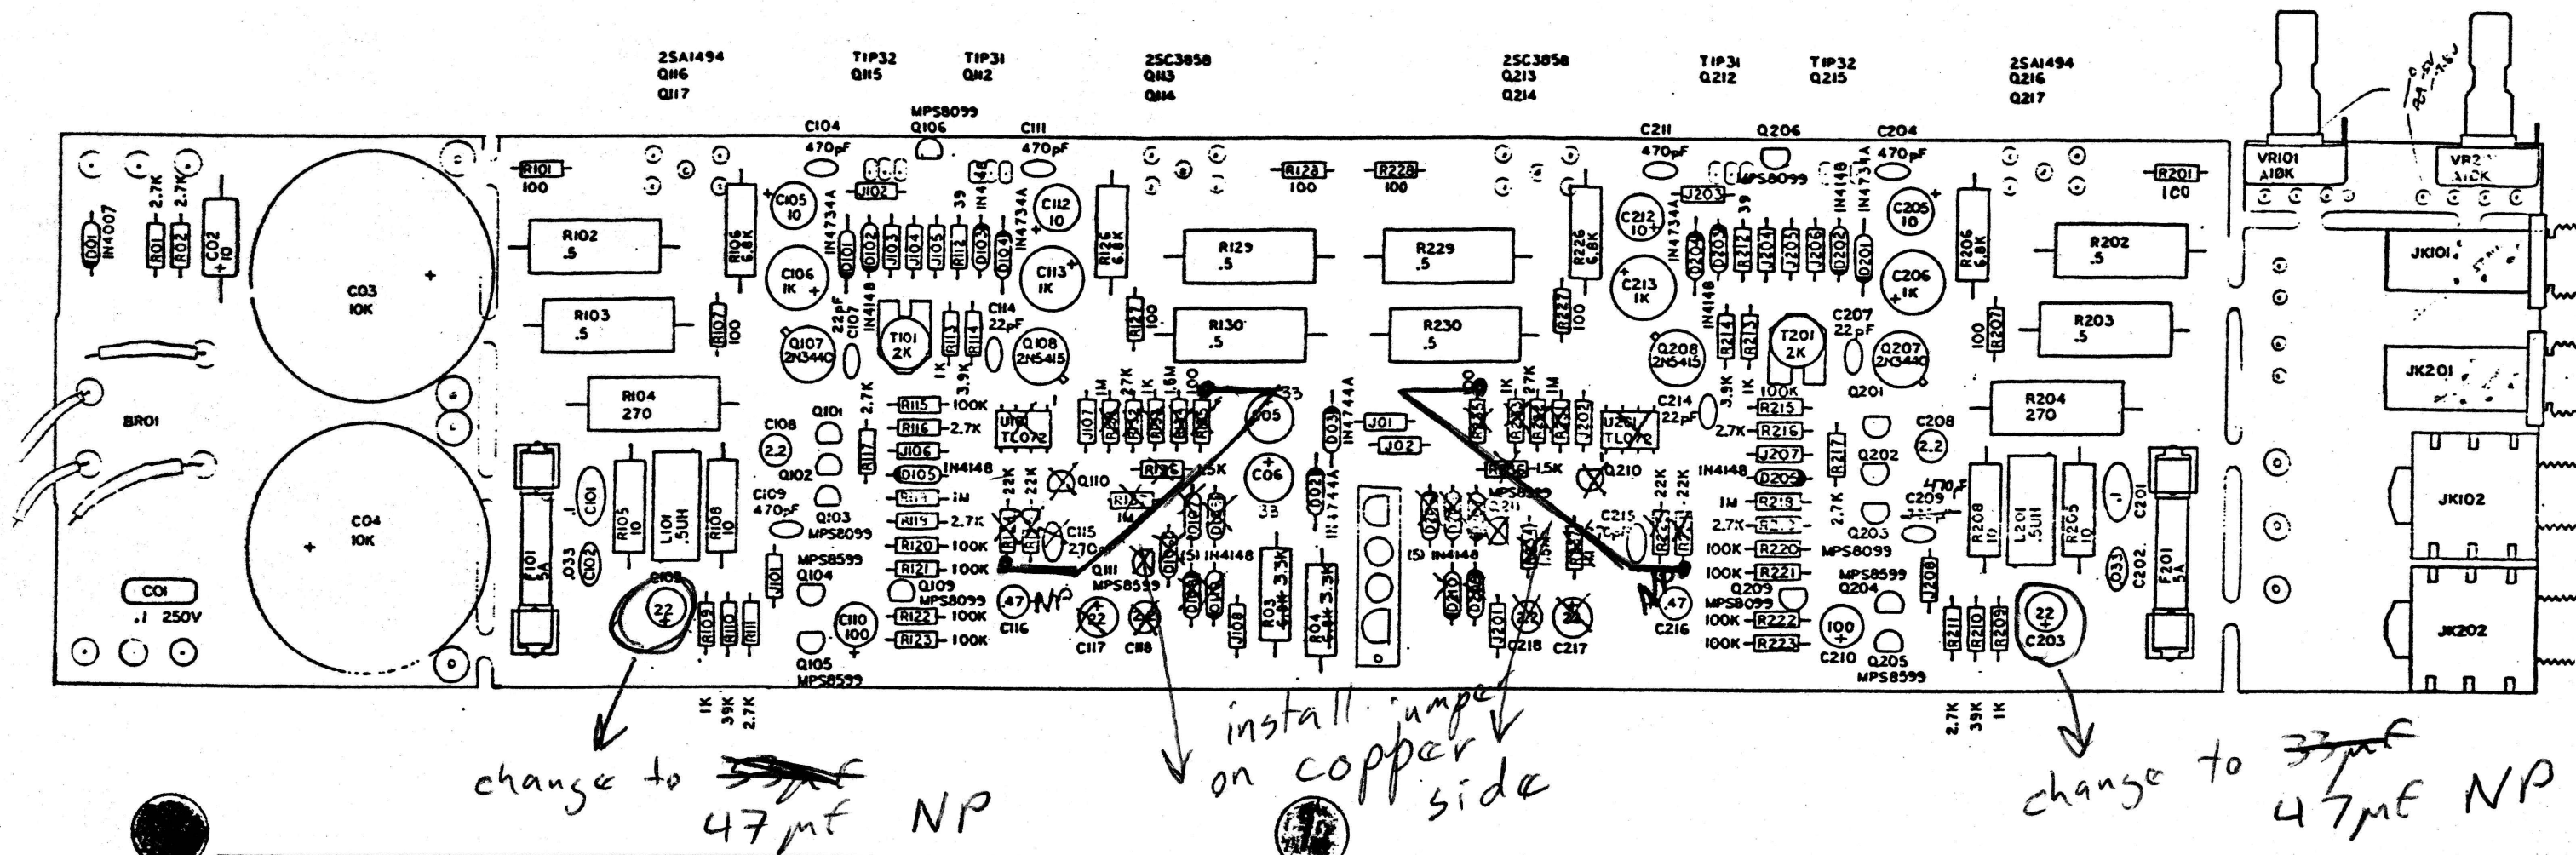

change to ~~337~~ 47 mt NP

install jumper
on copper side

↓
change to ~~33μF~~
47μF NP

B500B & G500S
ASSEMBLY DWG NO: B627 A RE
11-2-90
STARTING SN GG 010001
ENDING SN
G500S

B500B
STARTING SN BPO10001
ENDING SN